



Unclassified

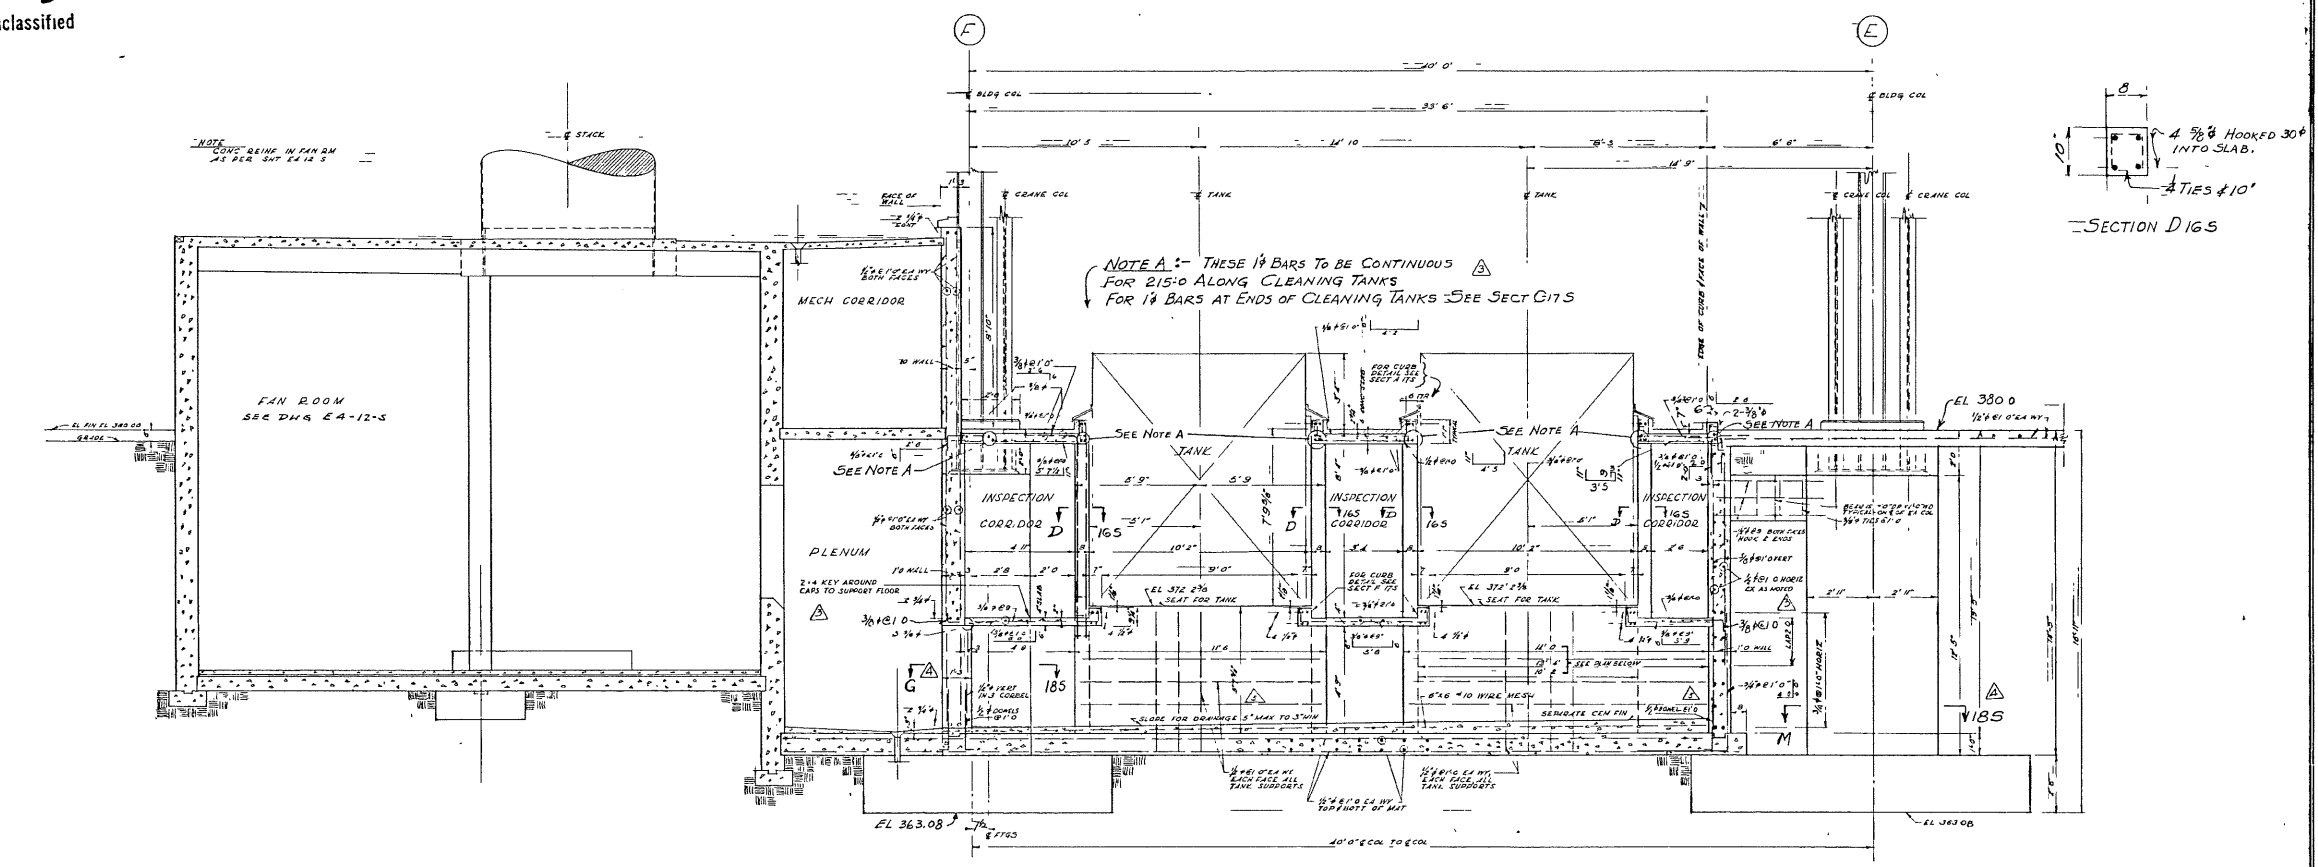

SECTION A-16.5  
TYPICAL SECTION THRU TANKS

Classification Changed to UNCLASSIFIED  
 (Insert Appropriate Classification Level and Category) (3/1/13)  
 By Authority of U.S. DOE (3/1/13)  
 Authority for Change of Classification (3/1/13)  
 By U.S. DOE (3/1/13)  
 (Exemption of Person Making Change) (3/1/13)  
 Verified by U.S. DOE (3/1/13)  
 (Signature of Person Verifying Change) (3/1/13)

BT Images, Inc  
00002000

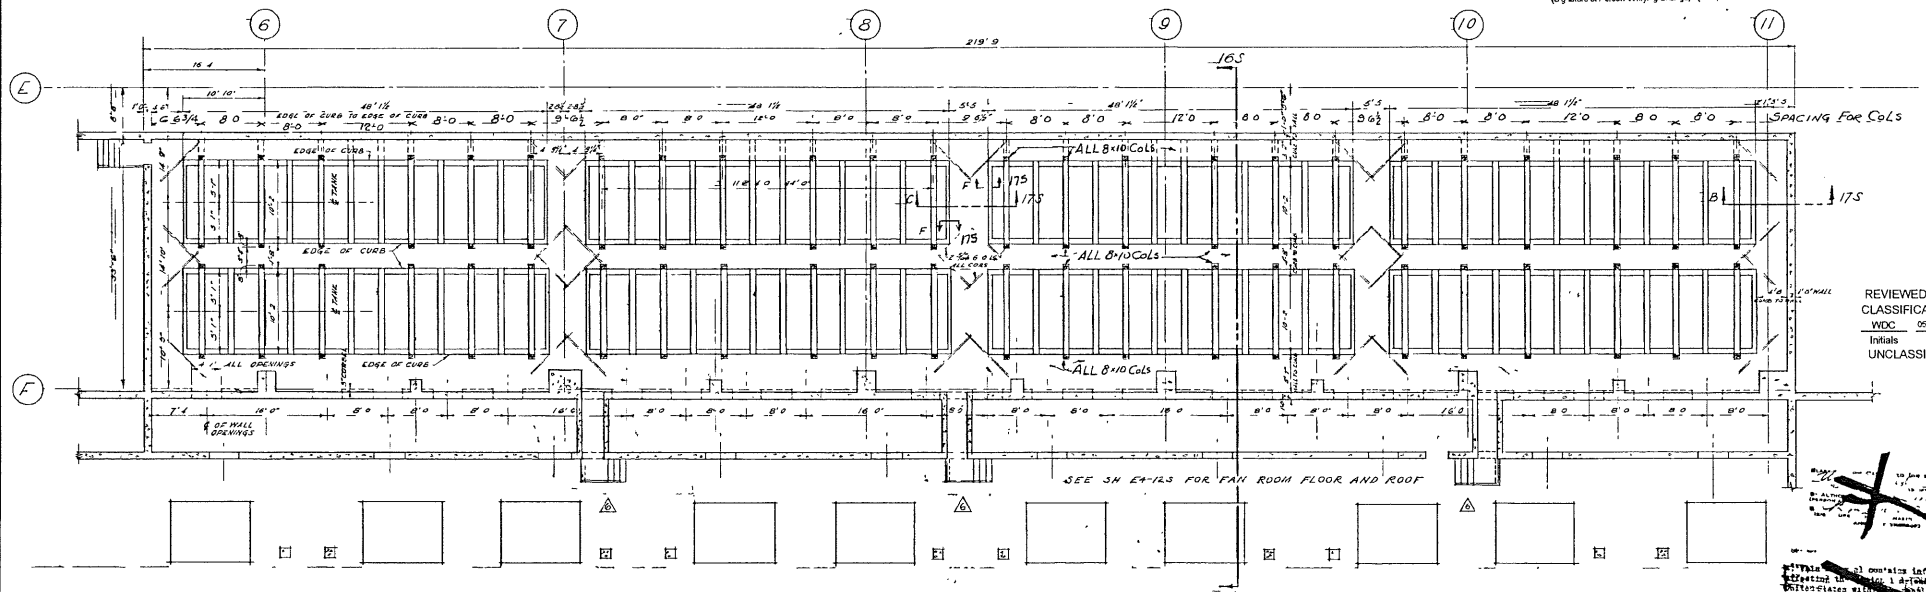

PLAN AT INSPECTION AND PLENUM LEVEL  
SCALE 1/4"=1'-0"

REVIEWED FOR CLASSIFICATION  
 WDC 05/05/2014  
 Initials Date  
 UNCLASSIFIED

NO.	DESCRIPTION	DATE
1	ISSUED FOR APPROVAL A	1/13/13
2	CONSTRUCTION B	5/14/13
3	REVISIONS	6/11/13
4	REVISIONS	6/11/13
5	REVISIONS FROM 2 TO 4	8/27/13
6	REVISIONS	12/10/13
7	AS BUILT	7/14/14

UNITED STATES ATOMIC ENERGY COMMISSION			
SMITH, HINCHMAN & GRYLLS, INC ARCHITECTS & ENGINEERS DETROIT 26 MICHIGAN			
PIT DETAILS FOR CLEANING TANKS			
DRAWING APPROVED-DATE	DRAWING APPROVED-DATE	DRAWING APPROVED-DATE	DRAWING APPROVED-DATE
<i>[Signature]</i> 5-18-14	R. A. TRAINER 5-18-14	C. J. ELLIOTT 5-18-14	
ARCHITECT ENGINEER	SEALING ENGINEER	DATE	DATE
<i>[Signature]</i>	<i>[Signature]</i>	5/18/14	5/18/14
PROJECT	BUILDING	ROOM	NO.
"C" PLANT	CLEANING C-400		8768
			E4-16-S

UNCLASSIFIED