
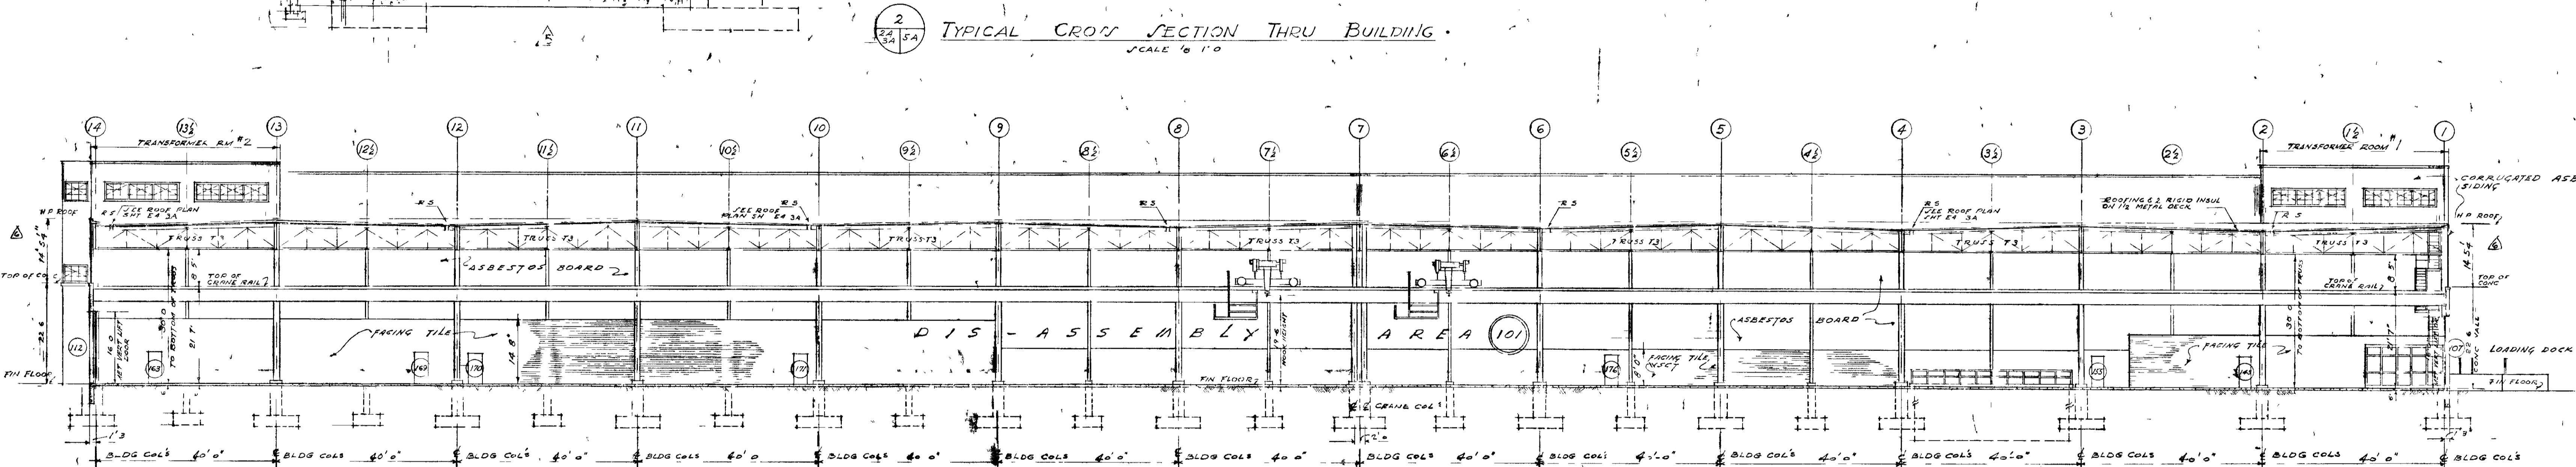
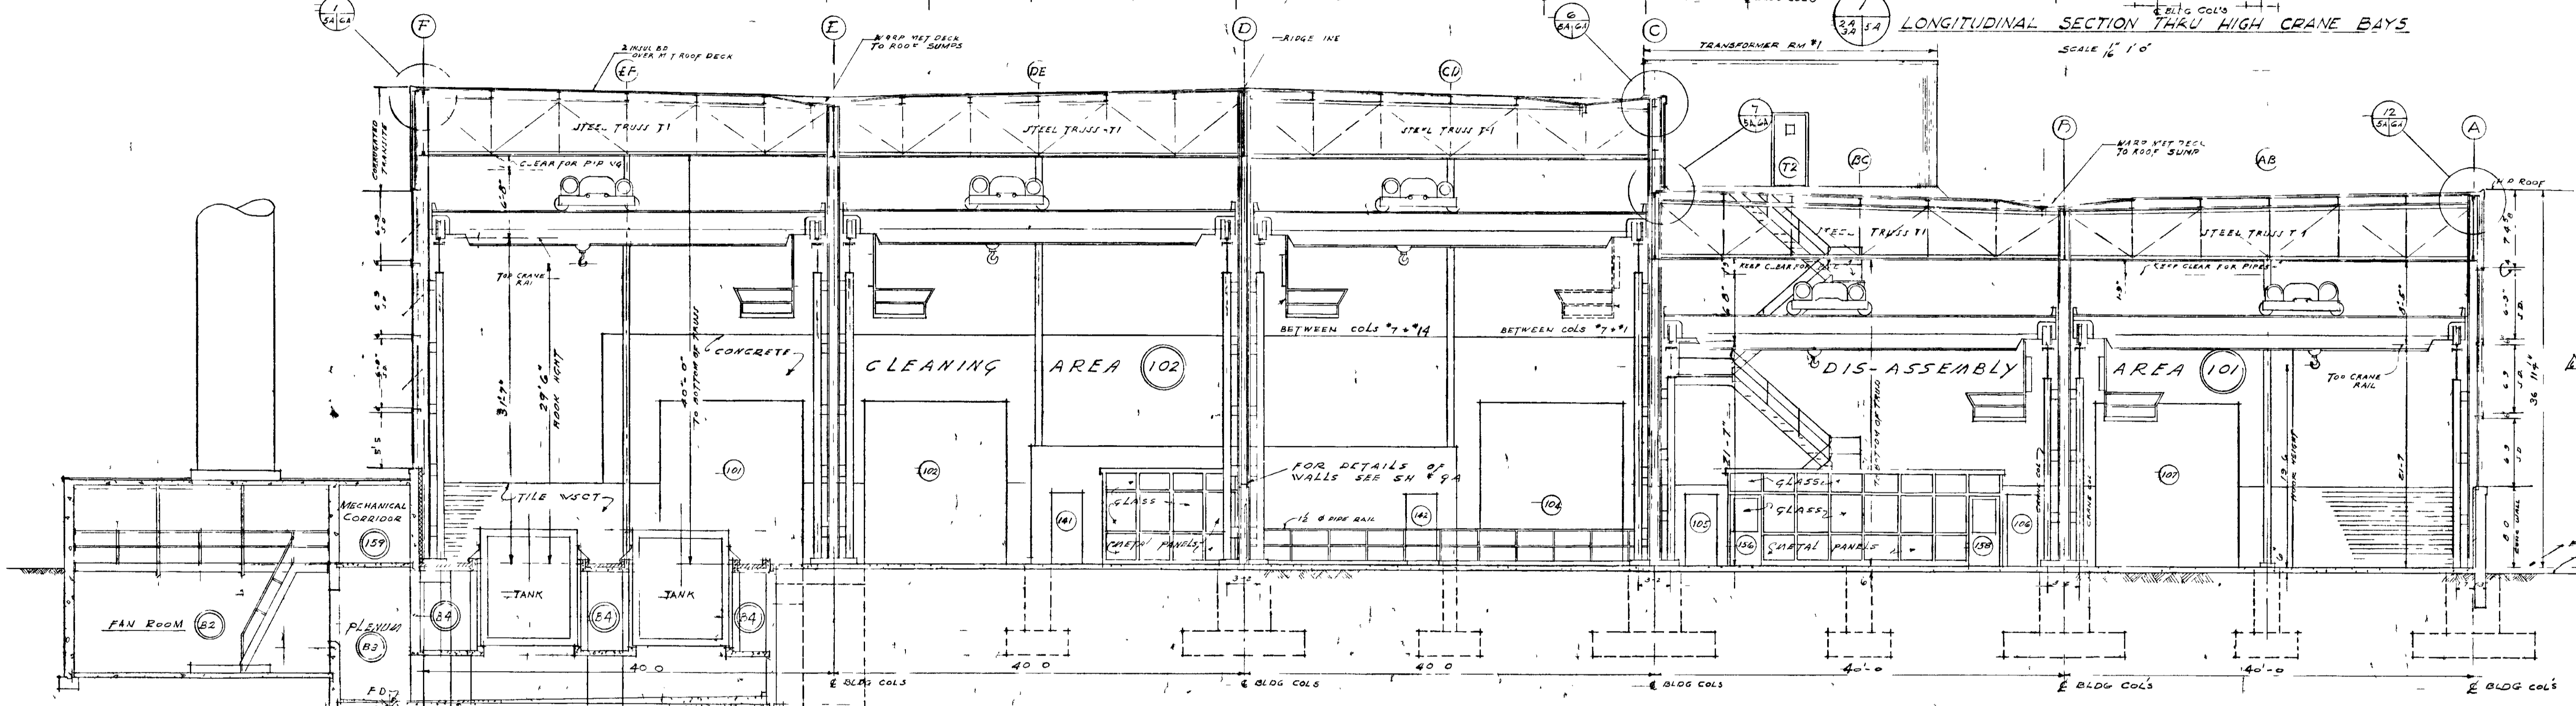


SECURITY INFORMATION

Unclassified

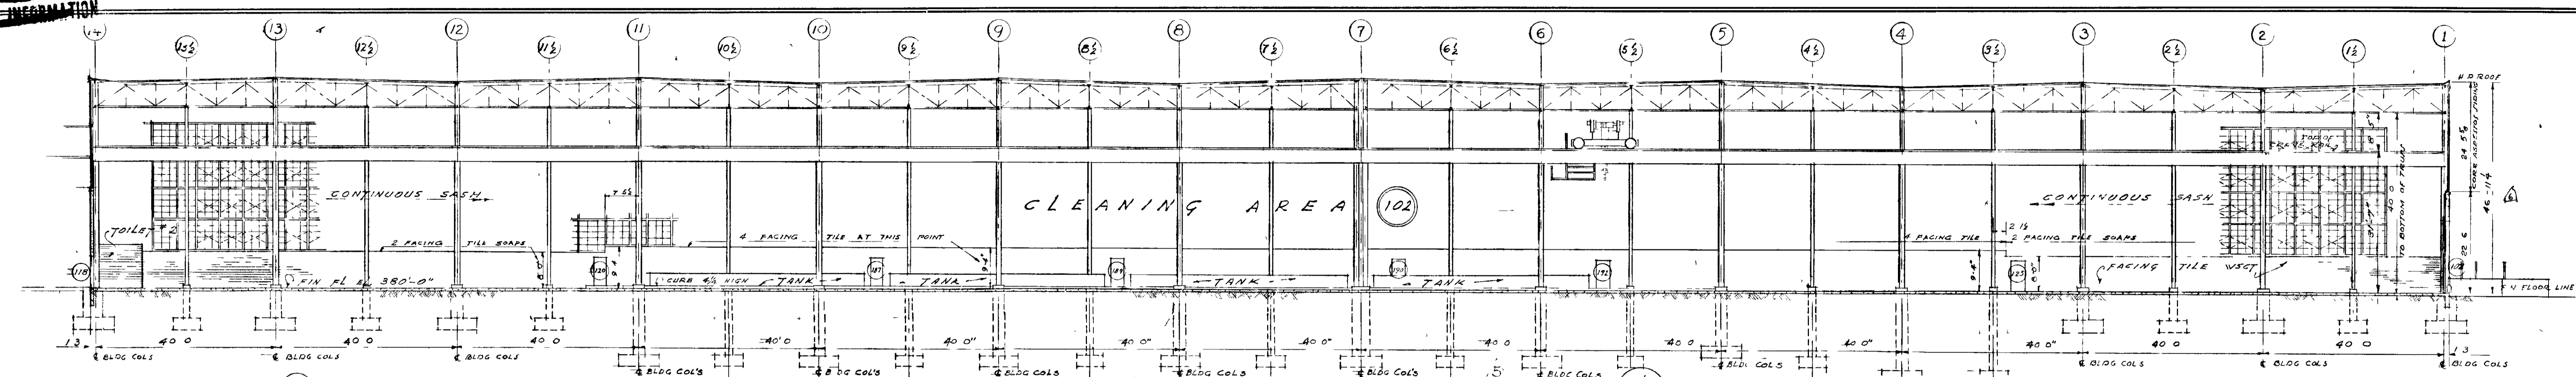


Classification Changed to UNCLASSIFIED  
 Insert Appropriate Classification Level and Category (Date)  
 By Authority of [Signature] (Date)  
 Verified by [Signature] (Date)

REVIEWED FOR CLASSIFICATION  
 sm 05/02/2014  
 Initials Date  
 UNCLASSIFIED

1ST REVIEWER	DATE	REASON FOR CHANGE
2ND REVIEWER	DATE	REASON FOR CHANGE
3RD REVIEWER	DATE	REASON FOR CHANGE
4TH REVIEWER	DATE	REASON FOR CHANGE
5TH REVIEWER	DATE	REASON FOR CHANGE

FPSC#2018 ESO#16570  
**FOR INFORMATION ONLY**

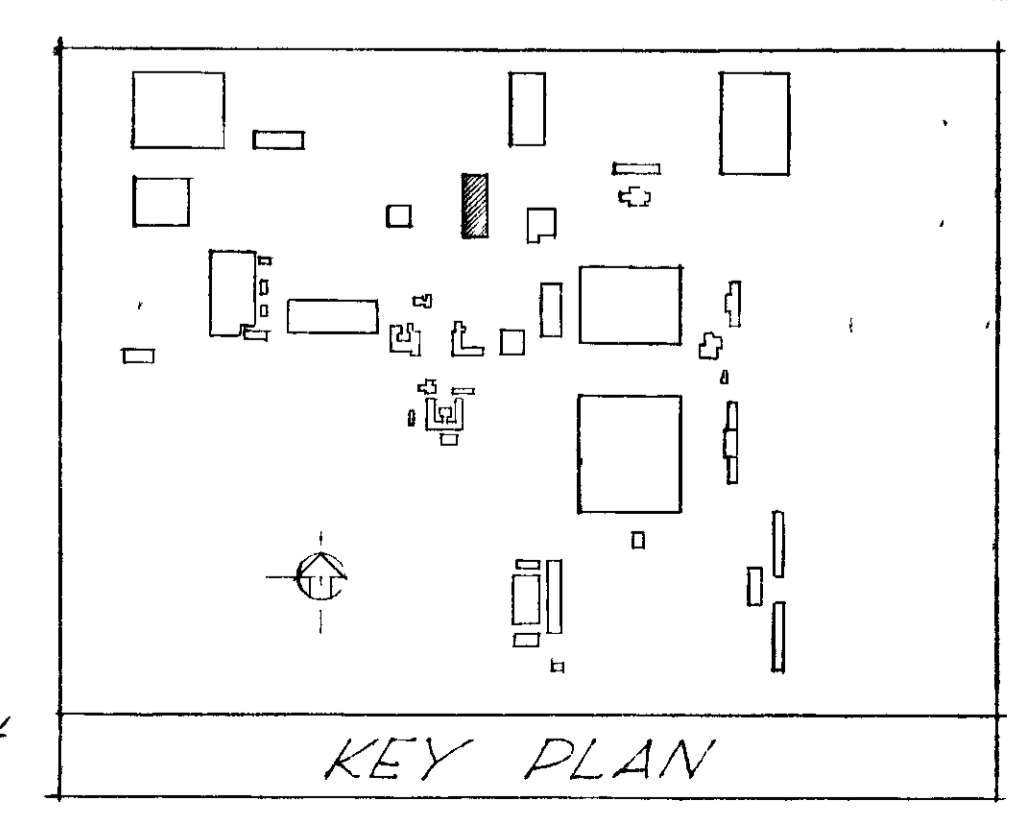

7	7/14/53	AS BUILT	W.B.	7/14/53
6	7-2-53	RELEASED, FINISHED & CHECKED DRAWINGS	R.J.B.	7-2-53
5	6-21-53	REVISIONS AS NOTED	R.J.B.	6-21-53
4	6-11-53	REVISIONS AS NOTED	R.J.B.	6-11-53
3	5-10-53	INTERIOR ELEVATIONS ADDED & TRANSFORMERS	R.J.B.	5-10-53
2	4-6-53	CONSTRUCTION	R.J.B.	4-6-53
1	4-2-53	APPROVAL	R.J.B.	4-2-53

ISSUED FOR: [Signature]

UNITED STATES  
 ATOMIC ENERGY COMMISSION

SMITH, HINCHMAN & GRYLLS, INC  
 ARCHITECTS & ENGINEERS  
 DETROIT 26 MICHIGAN

DRAWING TITLE  
**LONGITUDINAL AND CROSS SECTIONS**

DRAWING APPROVED	DATE	DRAWING APPROVED	DATE
[Signature]	4-2-53	[Signature]	4-2-53
ARCHITECT ENGINEER	DATE	CHEMICAL ENGINEER	DATE
[Signature]	4-2-53	[Signature]	4-2-53
IN CHARGE	DATE	DATE	DATE
[Signature]	4-2-53	[Signature]	4-2-53
PROJECT	NO.	SHEET	NO.
"C" PLANT	CLEANING C-400	E4-5-A	8768

THIS DRAWING IS THE PROPERTY OF THE UNITED STATES GOVERNMENT AND IS LOANED TO YOU BY THE UNITED STATES GOVERNMENT. IT IS TO BE RETURNED TO THE UNITED STATES GOVERNMENT AT THE END OF THE LOAN PERIOD. IT IS NOT TO BE REPRODUCED OR TRANSMITTED IN ANY FORM OR BY ANY MEANS, ELECTRONIC OR MECHANICAL, INCLUDING PHOTOCOPYING, RECORDING, OR BY ANY INFORMATION STORAGE AND RETRIEVAL SYSTEM, WITHOUT PERMISSION IN WRITING FROM THE UNITED STATES GOVERNMENT.

Unclassified

UNCLASSIFIED

MICROFILMED