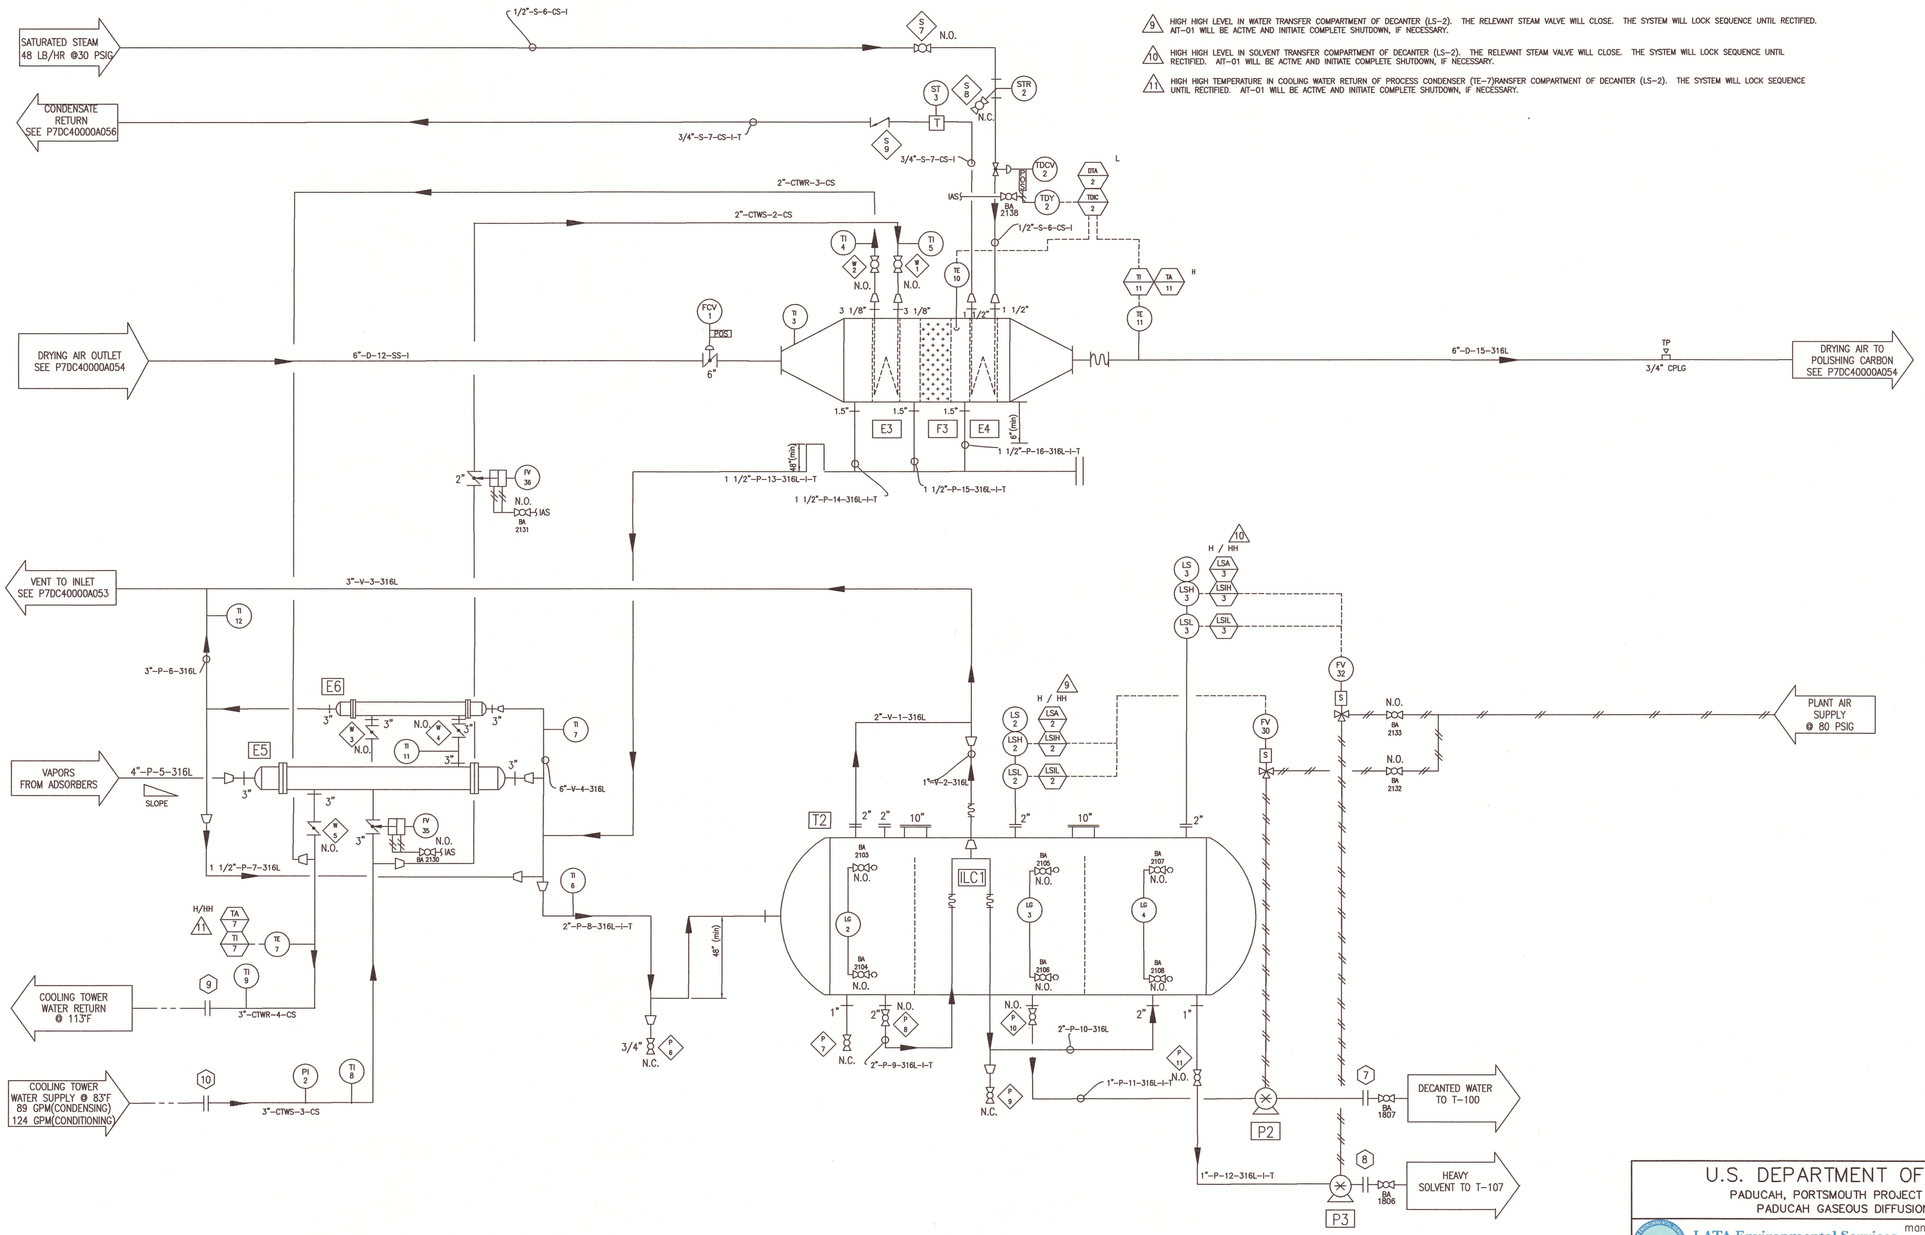

9 HIGH HIGH LEVEL IN WATER TRANSFER COMPARTMENT OF DECANTER (LS-2). THE RELEVANT STEAM VALVE WILL CLOSE. THE SYSTEM WILL LOCK SEQUENCE UNTIL RECTIFIED. AIT-01 WILL BE ACTIVE AND INITIATE COMPLETE SHUTDOWN, IF NECESSARY.

10 HIGH HIGH LEVEL IN SOLVENT TRANSFER COMPARTMENT OF DECANTER (LS-2). THE RELEVANT STEAM VALVE WILL CLOSE. THE SYSTEM WILL LOCK SEQUENCE UNTIL RECTIFIED. AIT-01 WILL BE ACTIVE AND INITIATE COMPLETE SHUTDOWN, IF NECESSARY.

11 HIGH HIGH TEMPERATURE IN COOLING WATER RETURN OF PROCESS CONDENSER (TE-7)RANSFER COMPARTMENT OF DECANTER (LS-2). THE SYSTEM WILL LOCK SEQUENCE UNTIL RECTIFIED. AIT-01 WILL BE ACTIVE AND INITIATE COMPLETE SHUTDOWN, IF NECESSARY.

REFERENCE DRAWINGS	DRAWING NO.

NO REPRESENTATION OR WARRANTY, EXPRESSED OR IMPLIED, IS MADE AS TO THE ACCURACY, COMPLETENESS OR USEFULNESS OF THE INFORMATION OR STATEMENTS CONTAINED IN THESE DRAWINGS, OR THAT THE USE OR DISCLOSURE OF ANY INFORMATION, APPARATUS, METHOD, OR PROCESS DISCLOSED IN THESE DRAWINGS MAY NOT INFRINGE PRIVATE RIGHTS OF OTHERS. NO LIABILITY IS ASSUMED WITH RESPECT TO THE USE OF, OR FOR DAMAGES RESULTING FROM THE USE OF ANY INFORMATION, APPARATUS, METHOD, OR PROCESS DISCLOSED IN THESE DRAWINGS. DRAWINGS MADE AVAILABLE FOR INFORMATION TO BIDDER ARE TO BE USED FOR OTHER PURPOSES AND ARE TO BE RETURNED UPON REQUEST OF THE FORWARDING CONTRACTOR.

SECTION NUMBER OR DETAIL LETTER
DRAWING ON WHICH SECTION OR DETAIL IS TAKEN
DRAWING ON WHICH SECTION OR DETAIL IS SHOWN
SECTION AND DETAIL KEY

LPE

--/--/--
DATE
PROFESSIONAL SEAL

REV.	DATE	DESCRIPTION	DRAWN BY	DRAFT CHK	PROJ ENGR	LEAD ENGR	CONF CTRL/ NUCL SFTY	FAC MGR	E&TS MGR
1	6-2-14	ISSUED FOR AS-BUILT C-400 PHASE IIA	KTW	DJH	DJH	JTP	LCV	JRW	KAS
0	6-26-13	ISSUED FOR AS-BUILT ASSIGNED LATA DRAWING NUMBER	KTW	NJB	DJH	JTP	SJD	JRW	PAC
F	11/15/12	FUSION ENVIRONMENTAL DRAWING PJ-2025-FD-001/3	MGG	PK	–	–	–	–	–

DRAWING REVISIONS

U.S. DEPARTMENT OF ENERGY
PADUCAH, PORTSMOUTH PROJECT OPERATIONS, PADUCAH GASEOUS DIFFUSION PLANT

LATA Environmental Services of Kentucky, LLC managed for the DEPARTMENT OF ENERGY under U.S. GOVERNMENT contract DE-AC30-10CC40020 Paducah, Kentucky

FUSION ENVIRONMENTAL

DOE CONTRACT NO. DE-AC30-10CC40020

PROJECT NAME:
C-400 REMEDIATION DESIGN

TITLE:
FLOW DIAGRAM
PROCESS UNIT
SHEET 3

EDCS CAD FILENAME	BUILDING	PLANT	CLASS
P7DC40000A055 REV 1.DWG	C-400	PGDP	U

SCALE:	TYPE	DRAWING NUMBER	REV
N.T.S.	D	P7DC40000A055	1