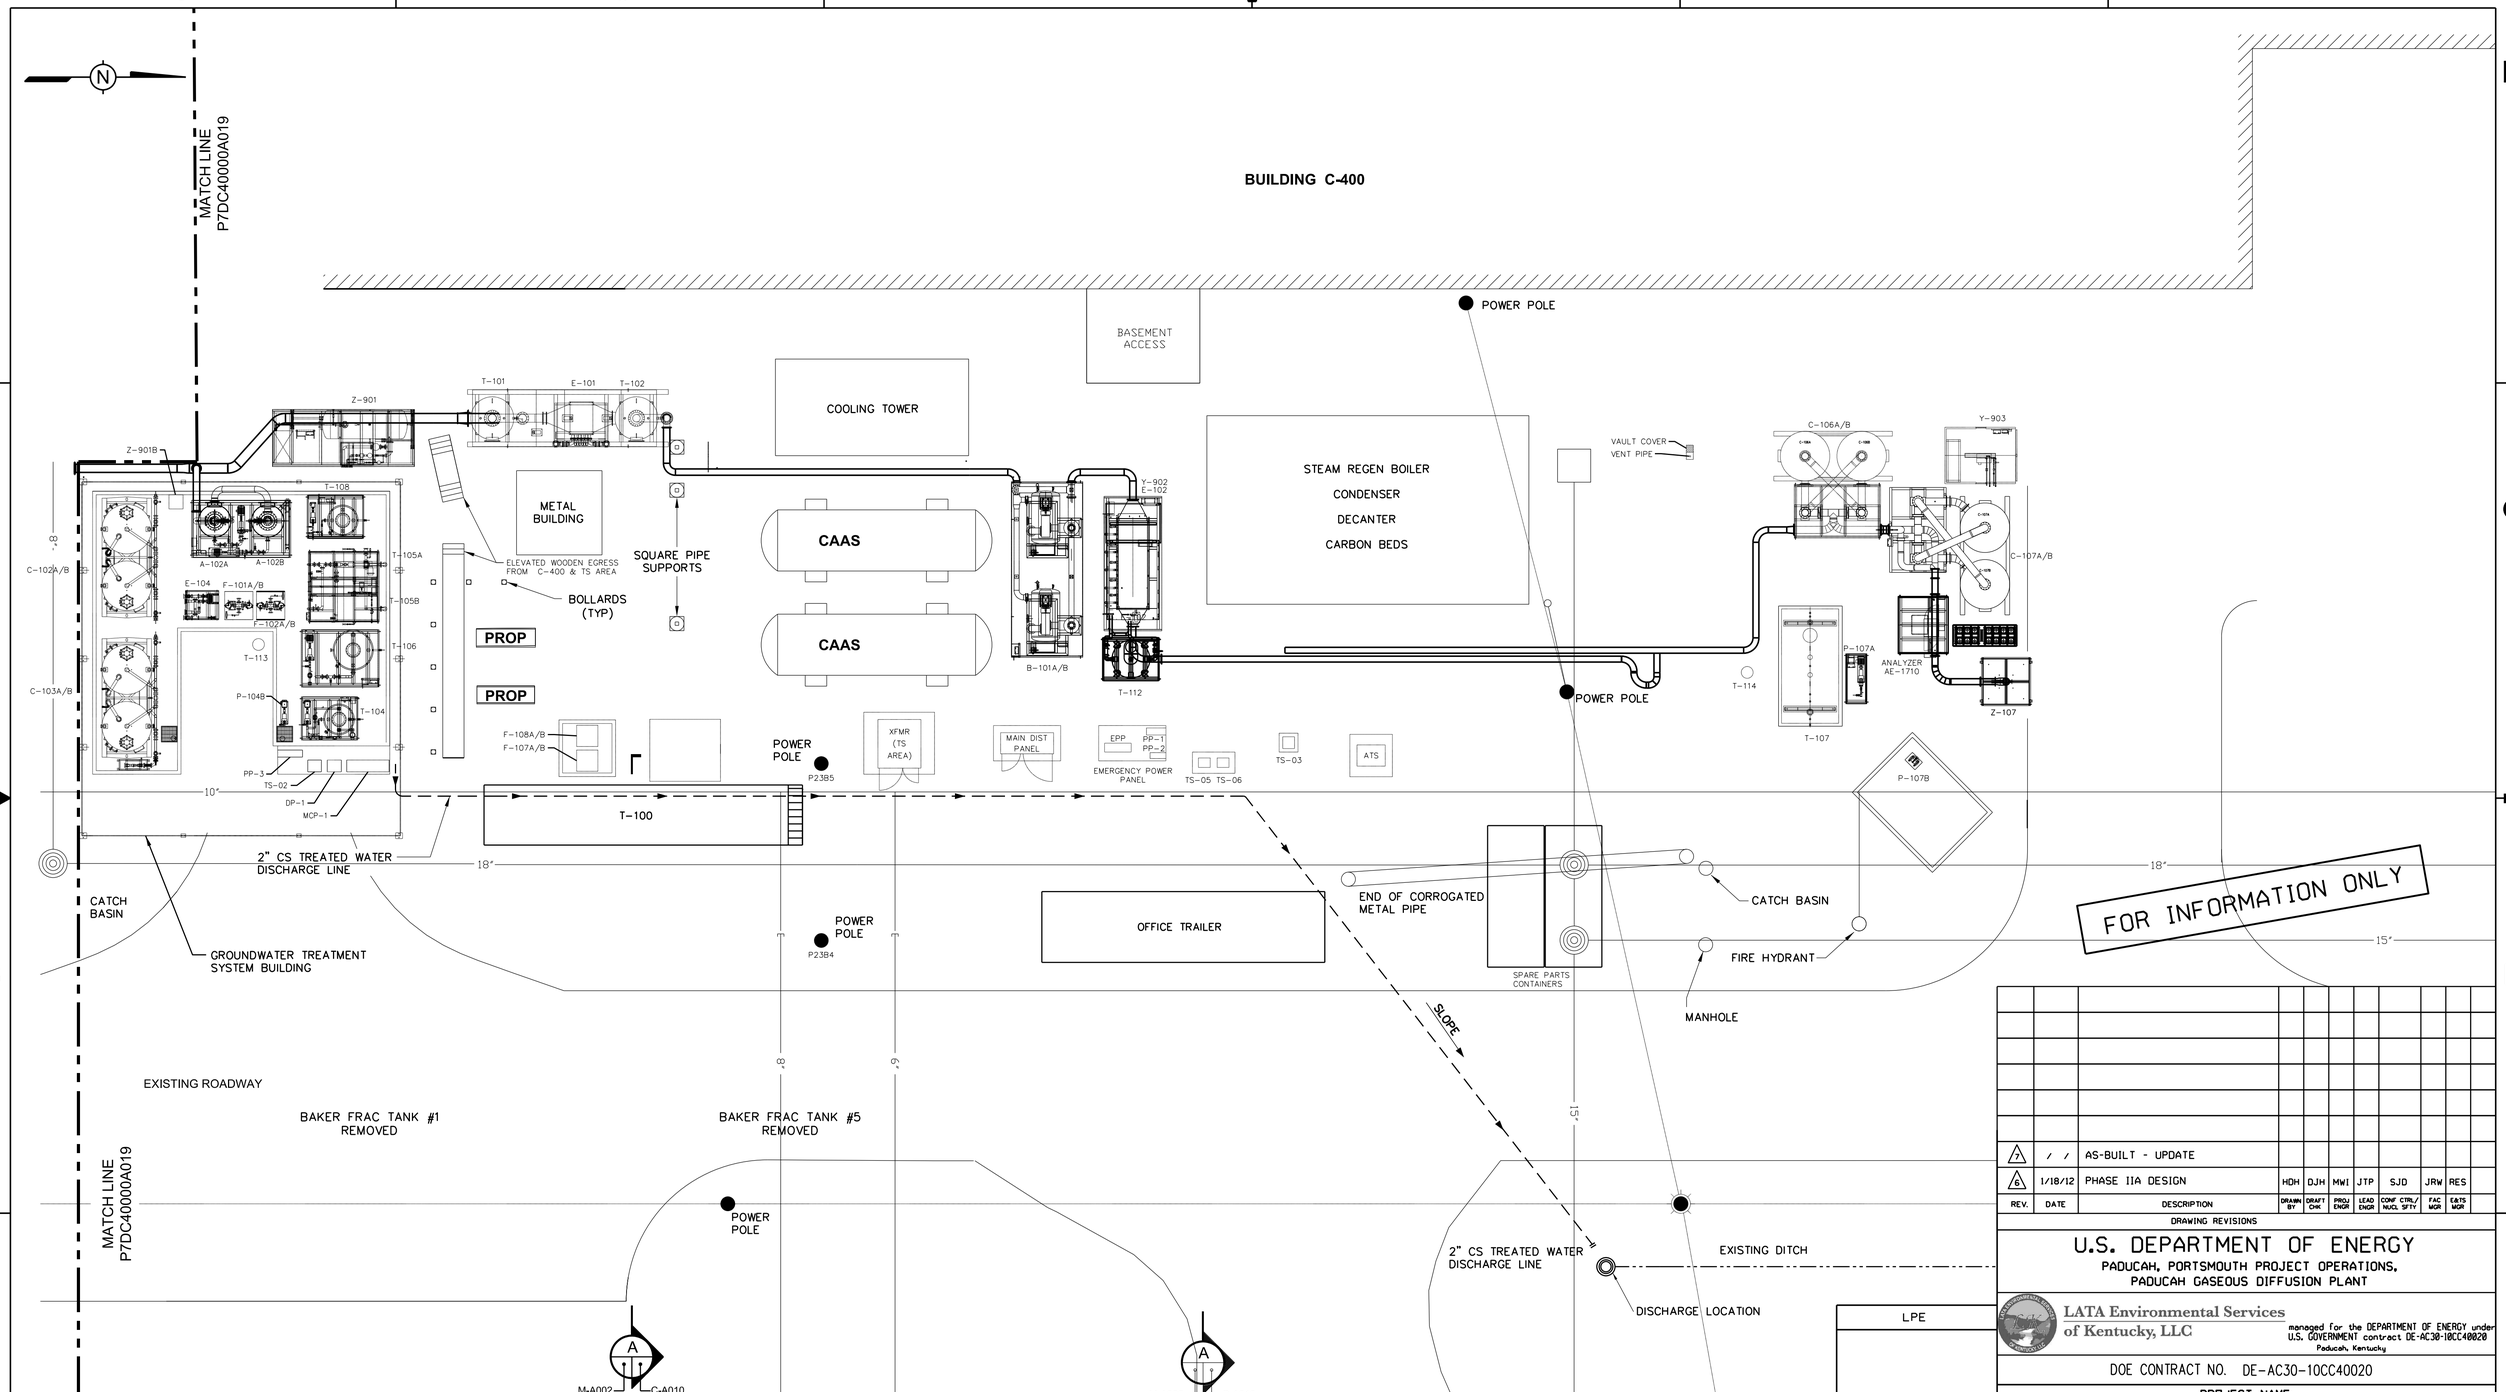

SITE VIEW

SCALE: 3/32" = 1'-0"

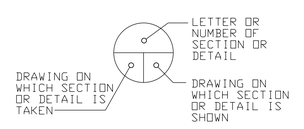

SECTION & DETAIL KEY

NOTES:

REV.	DATE	DESCRIPTION	DRAWN BY	DRAFT CHK	PROJ ENGR	LEAD ENGR	CONF CTRL/ NUCL SFTY	FAC MGR	E&TS MGR
7	/ /	AS-BUILT - UPDATE							
6	1/18/12	PHASE IIA DESIGN	HDH	DJH	MWI	JTP	SJD	JRW	RES

DRAWING REVISIONS

U.S. DEPARTMENT OF ENERGY
PADUCAH, PORTSMOUTH PROJECT OPERATIONS,
PADUCAH GASEOUS DIFFUSION PLANT

LATA Environmental Services of Kentucky, LLC
managed for the DEPARTMENT OF ENERGY under U.S. GOVERNMENT contract DE-AC30-10CC40020
Paducah, Kentucky

DOE CONTRACT NO. DE-AC30-10CC40020

PROJECT NAME:
C-400 REMEDIATION DESIGN

TITLE:
GROUNDWATER/VAPOR TREATMENT SYSTEM
TREATMENT AREA
EQUIPMENT LAYOUT

LPE

--/--/--

DATE

PROFESSIONAL SEAL

CAD FILE NAME	BUILDING	PLANT	CLASS
M7DC40000A002 REV 7.DWG	C-400	PGDP	U

SCALE:	DRAWING NUMBER	REV
AS SHOWN	M7DC40000A002	7