RESTRICTED
SECURITY INFORMATION

Unclassified

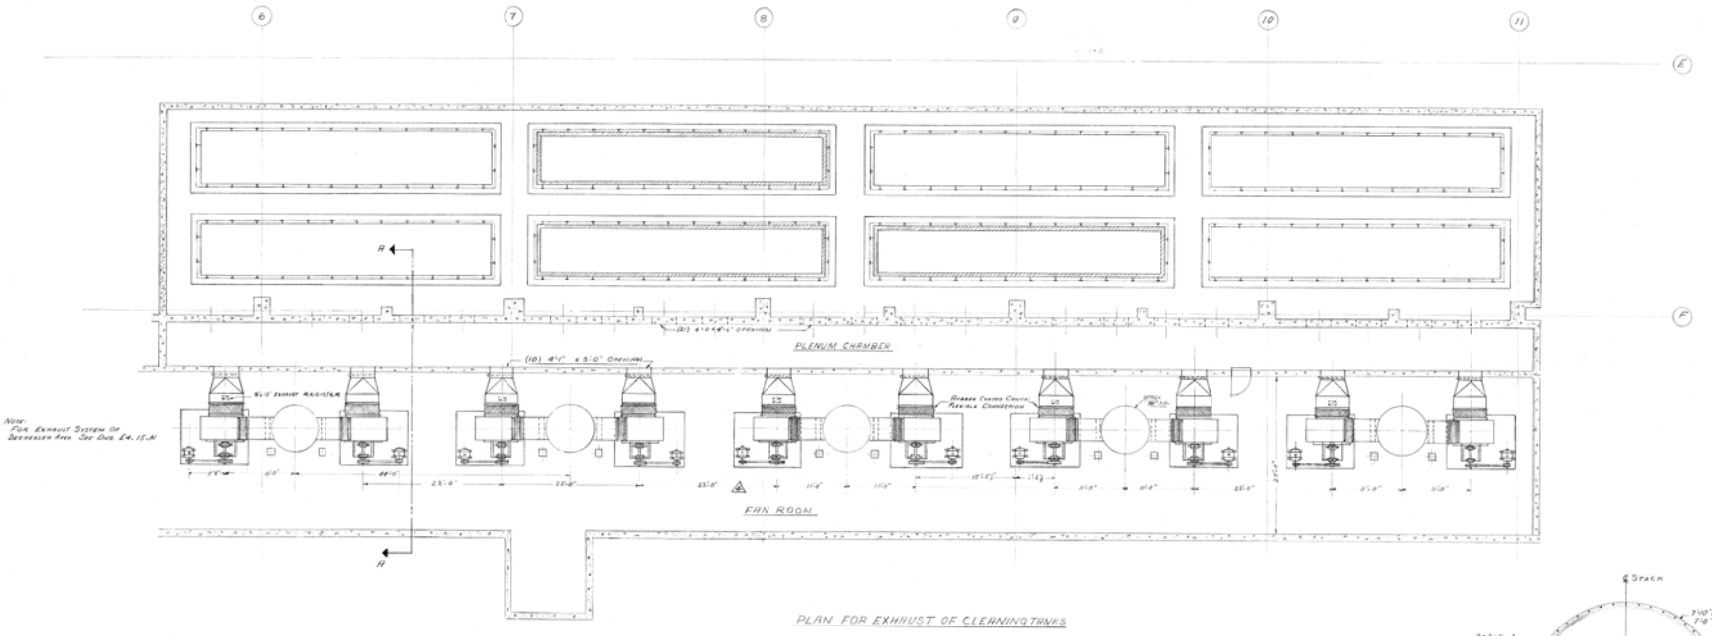

PLAN FOR EXHAUST OF CLEANING TANKS
Scale 1/8" = 1'-0"

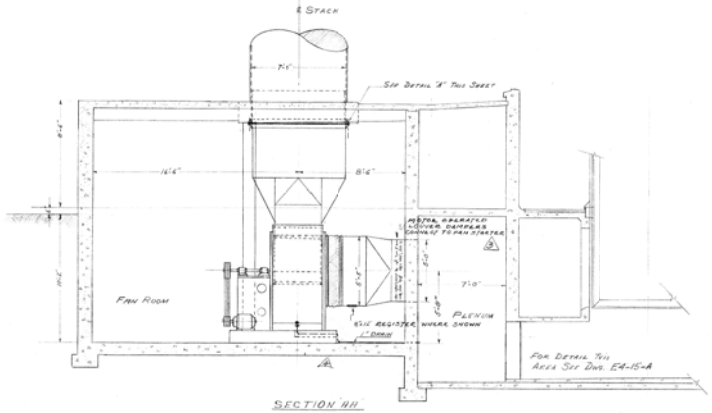

Scale 1/8" = 1'-0"

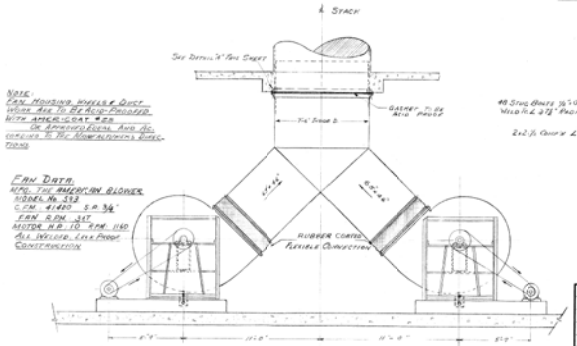

TYPICAL FAN CONNECTION
Scale 1/4" = 1'-0"

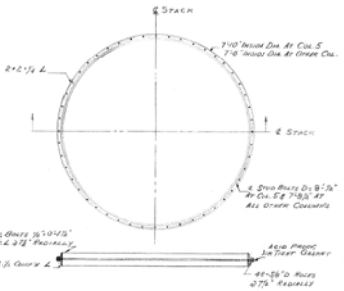

DETAIL "A"
Scale 1½" = 1'-0"

REV. NO.	DATE	ISSUED FOR	BY	APP. DATE
5	7-21-53	AS BUILT	GF	7-21-53
4	2-7-52	REVISION REQUEST NO. 323		
3	6-15-51	ROAD MOTOR OPERATED DAMPERS AS		
2	4-4-51	CONSTRUCTION "A"		4-5-51
1	10-6-50	ISSUED FOR APPROVAL "A"		

UNITED STATES
ATOMIC ENERGY COMMISSION

SMITH, HINCHMAN & GRYLLS, INC.
ARCHITECTS & ENGINEERS
DETROIT 26, MICHIGAN

DRAWING TITLE

PLAN & ELEVATIONS OF CLEANING TANK EXHAUST SYSTEM

DRAWING APPROVED—DATE	DRAWING APPROVED—DATE	DRAWING APPROVED—DATE
O.F. Ketchum 4-5-51	R.A. Wilcox 4-5-51	R.J. Brown 4-5-51
ARCHITECT ENGINEER	CARBIDE CARBON CHEM. DIV.	U. C. ENGINEER

DRAWN	DATE	CHECKED	DATE	JOB
M.H.S. & Y.K.H.	7-7-53	H.P.J.	4-2-47	8768
IN CHARGE	DATE	APPROVED	DATE	
H.P.J.	7-7-53	[signature]	7-7-53	
PROJECT		BUILDING		SHEET
"C" PLANT		CLEANING C-400		E4-9-M

Classification Changed to UNCLASSIFIED
(Insert Appropriate Classification Level and Category (s) (if any))
By Authority of E.D.S.T. DOE Letter 8-7-97
(Authority for Changes in Classification Only)
By [signature] 9-8-98
(Signature of Person Making Change(s))
Verified by [signature] 9/28/98
(Signature of Person Verifying Change)

REVIEWED FOR CLASSIFICATION
II 05/05/2014
Initials Date
UNCLASSIFIED

BT Images, Inc.
00001862

UNCLASSIFIED

RESTRICTED
SECURITY INFORMATION